



* LIFTING WEIGHT : 166,600 kg

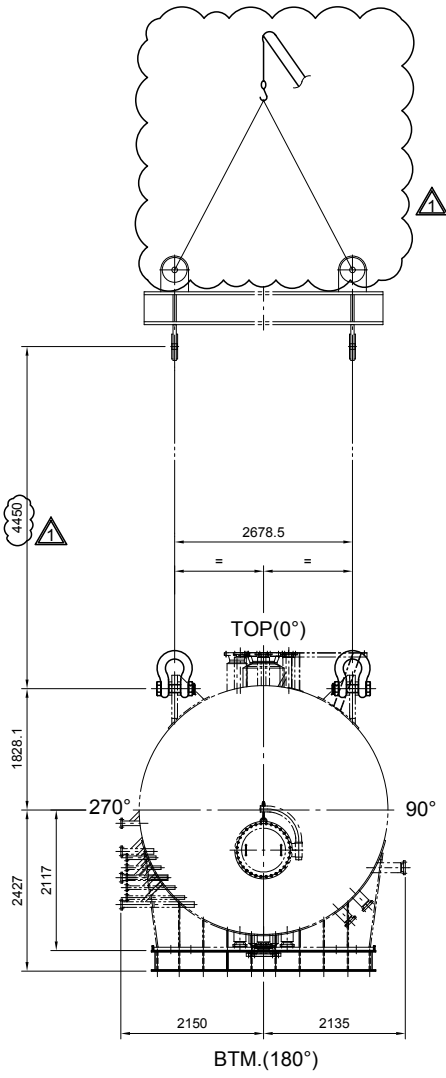


VIEW "A"-"A" (ERECTION)
(SCALE = 1 : 55)

"A" →

→ "A"

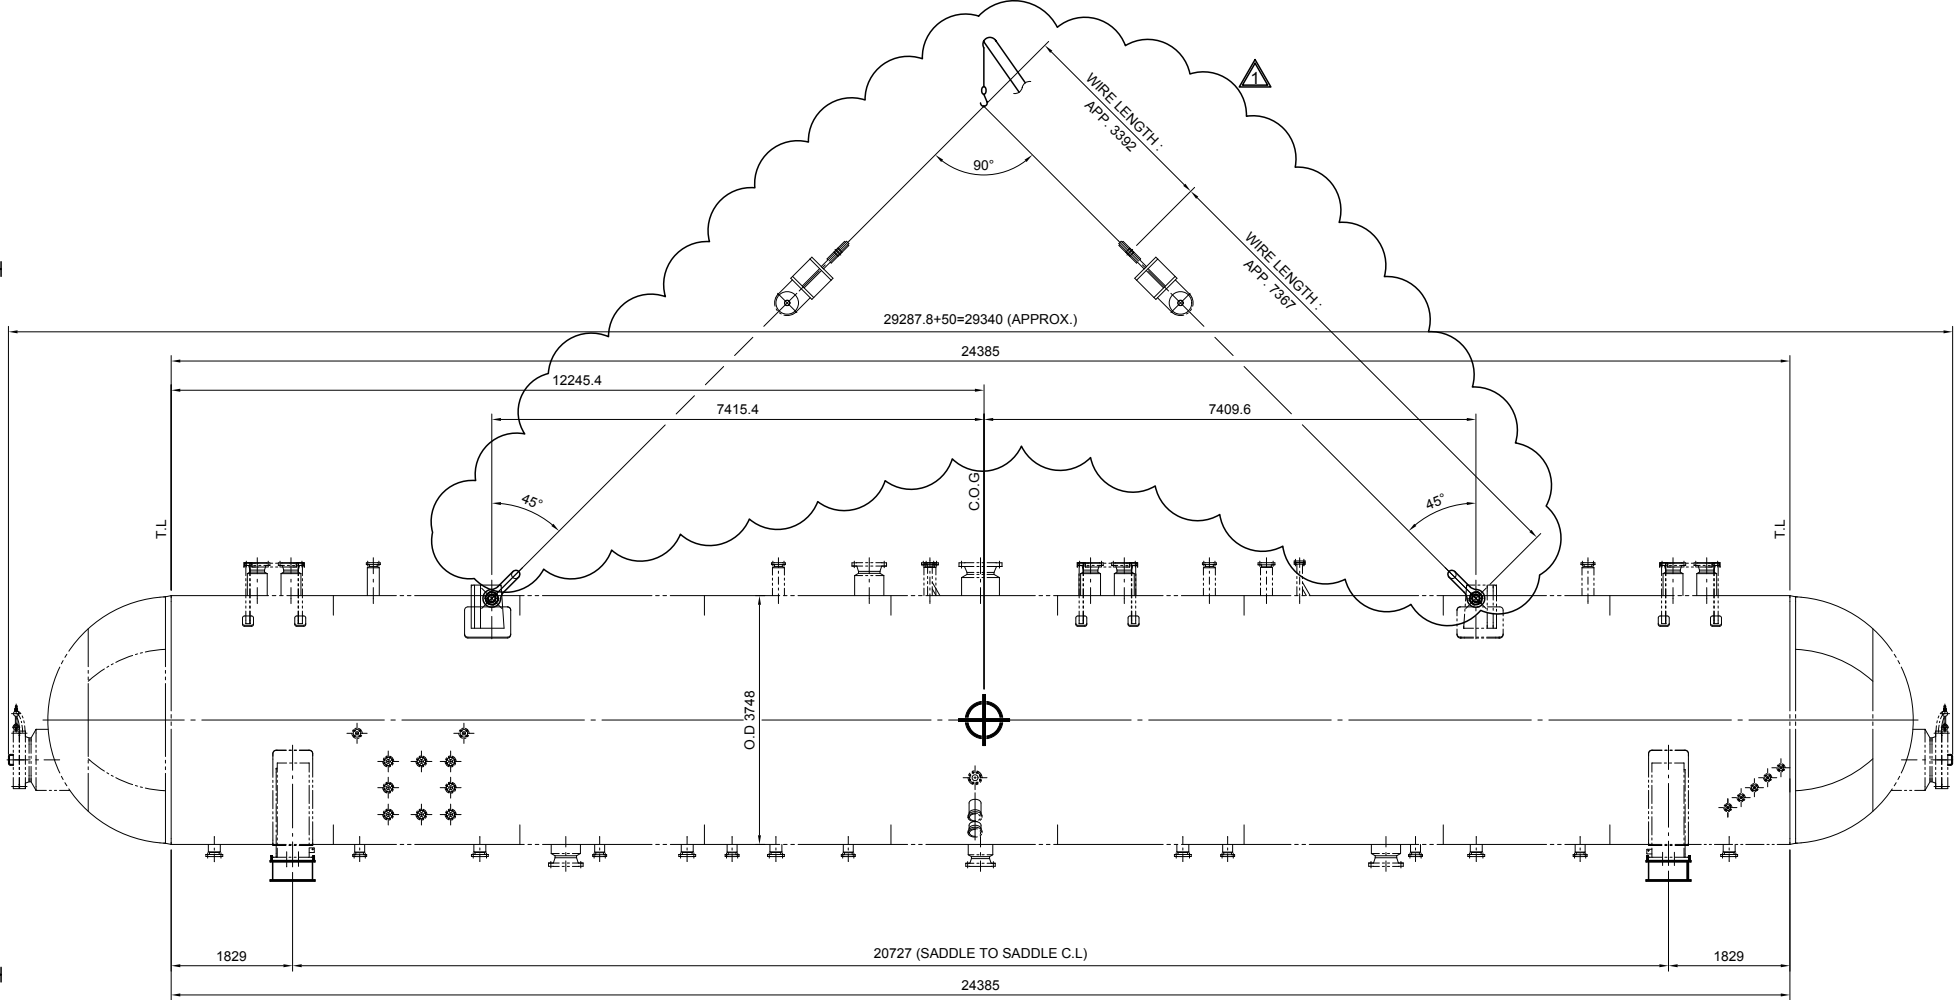

ELEVATION VIEW (ERECTION)
(SCALE = 1 : 55)

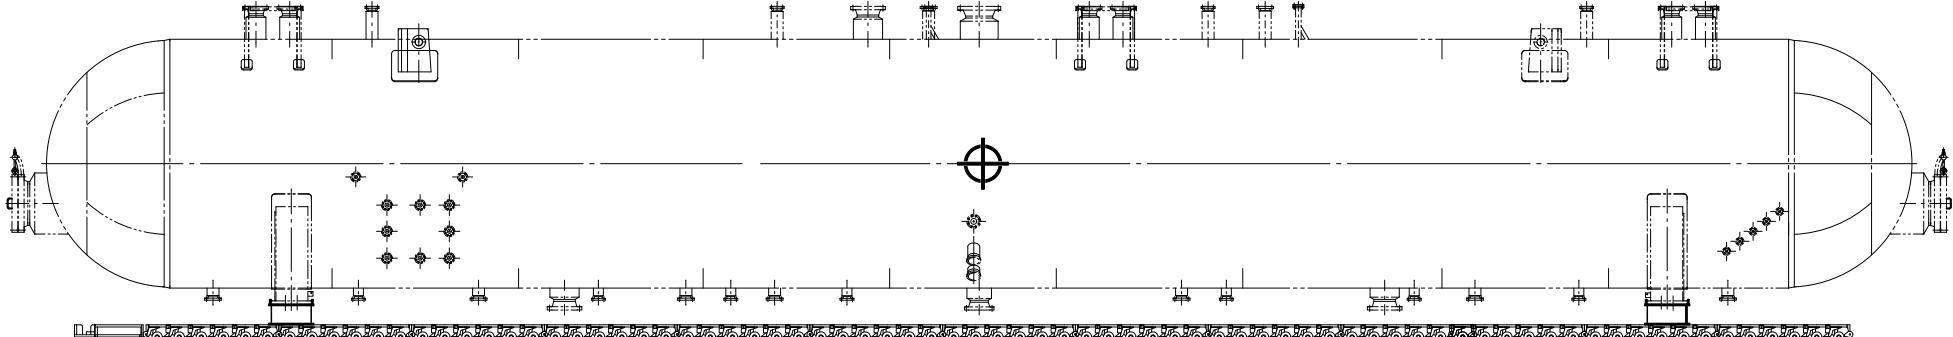

TRANSPORTATION
(SCALE = 1 : 55)

A S M E		Certification Mark (U) Designator
MFR. SERIAL NO.		WHC-26-001-01.02
WHC WORK ORDER NO.		WHC-26-001
VENDOR DATA STATUS		
☐ 1 : APPROVED. SUBMIT FINAL		
☐ 2 : APPROVED WITH COMMENTS SUBMIT CORRECTED FINAL		
☐ 3 : NOT APPROVED (REVISE AND RESUBMIT)		
☐ 4 : APPROVED NOT REQUIRED INFORMATION ONLY		
NOTE: Permission to proceed does not constitute acceptance or approval of design details, calculations, Analysis, test methods or materials developed or selected by the supplier and does not relieve supplier from full compliance with contractual obligations.		
REVIEW DATE:		
ENGINEER		LEAD ENGINEER

△					
△					
△					
△					
△	19.AUG.2026	ISSUED FOR CONSTRUCTION	G&G	Y.C.JEONG	S.S.KIM
△	30.JUN.2026	ISSUED FOR CONSTRUCTION	G&G	Y.C.JEONG	S.S.KIM
△	01.JUN.2026	ISSUED FOR APPROVAL	G&G	Y.C.JEONG	S.S.KIM
REV.	DATE	DESCRIPTION	PREPARED	REVIEWED	APPROVED
		OWNER 			
JOB NO. D25R0RA146		TAG NO. B10-2802/2852			
DRAWN	G&G	PROJECT 2027 T/A DESALTER REPLACEMENT			
CHECKED	Y.C.JEONG	TITLE LIFTING ARRANGEMENT DRAWINGS - DESALTERS (B10-2802/2852)			
APPROVED	S.S.KIM	CLASSIFICATION NO.			
SCALE	DATE DRAWN	OWNER DWG. NO. VP-D25R0RA146-10-28-02-062			REV. 
SEE DWG.	19.AUG.2026	SLB DWG. NO. P-SK002-002-ME-490-0001			
					
					